

# BENSALEM TOWNSHIP

Building and Planning Department  
2400 Byberry Road • Bensalem PA 19020  
215-633-3644 • FAX 215-633-3653

Exhibit Z-4

## Zoning Hearing Board

Appeal Number: 2016-507

### Township of Bensalem, Bucks County, Pennsylvania Notice of Appeal

Appeal is hereby made by the undersigned from the action of the Zoning Officer.

Check applicable item(s):

RECEIVED

JUL 12 2016

BENSALEM TOWNSHIP  
BUILDING AND PLANNING

- ☐ Certification of Non-Conforming Use
- ☐ Application for Validity Challenge
- ☒ Administrative Officer in refusing my application for a building permit dated: 07/07/2016
- ☒ Special Exception
- ☐ Variance from the terms of the Zoning Ordinance of the Township of Bensalem

Appellant Name: Stanislav MELIKOV

Address: 3020 WISTAR CT  
BENSALEM, PA 19020

Phone No. [REDACTED]

Owner's Name: Stanislav MELIKOV

Address: 3020 WISTAR CT  
BENSALEM, PA 19020

Phone No. [REDACTED]

Attorney Name: N/A

Address:

Phone No.

Interest of appellant, if not owners (agent, lessee, etc.): N/A

1. Application relates to the following:

Check items if applicable:

- |  |  |
|--|--|
| <input type="checkbox"/> Use               | <input type="checkbox"/> Lot Area          |
| <input type="checkbox"/> Height            | <input type="checkbox"/> Yards             |
| <input type="checkbox"/> Existing Building | <input type="checkbox"/> Proposed Building |
| <input type="checkbox"/> Occupancy         |  |

☒ Other: (describe) use of pool for which permit  
application was submitted  
and rejected 07/07/2016

2. Brief description of Real Estate affected:

Tax Parcel Number: 02-090-156

Location: 3020 WISTAR CT, BENSALEM PA 19020

Lot Size: 100' x 31'

Present Use: Primary Residence

Proposed Use: N/A

Present Zoning Classification: \_\_\_\_\_

Present Improvement upon Land: House, garage

Deed recorded at Doylestown in Deed Book Inst # Page E2013075108

3. If this is an appeal to challenge, provide statement and/or basis for challenge to the validity of the zoning ordinance.

N/A

4. If this is an Appeal from action of the Zoning Administrative Officer then complete the following:

Date Determination was made: N/A

Your statement of alleged error of Zoning Administrative Office: N/A

5. Specific reference to section of the Zoning Ordinance upon which application for special exception or variance is based (if special or variance is desired):

6. Action desired by appellant or applicant (statement of relief sought or special exception or variance desired):

I'd like the zoning Board to approve this appeal as an  
exception 232-588(a)

7. Reasons appellant believes board should approve desired action (refer to section or sections of ordinance under which it is felt that desired action may be allowed, and not whether hardship is (or is not) claimed, and the specific hardship.

I'd like my children to use the pool to improve the health.  
I believe that the pool does not effect anybody's interest

8. Has previous appeal or application for special exception or variance been filed in connection with these premises?

☐ YES ☒ NO

Specifications of errors must state separately the appellant's objections to the action of the zoning administrative office with respect to each question of law and fact which is sought to be reviewed.

N/A

I, hereby depose and say that all of the above statements and the statements contained in any papers or plans submitted herewith, are true to the best of my knowledge and belief.

Appellant's or Owner's Signature


Date

Sworn to and subscribed before me this

11th day of July 2002016


Notary Public


My commission expires: 4-15-19

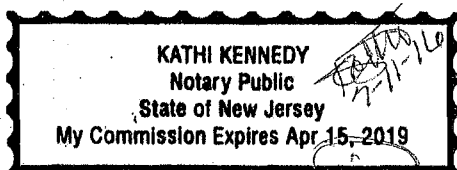

Lot 156

3020 Wistar Ct Bensalem PA 19020

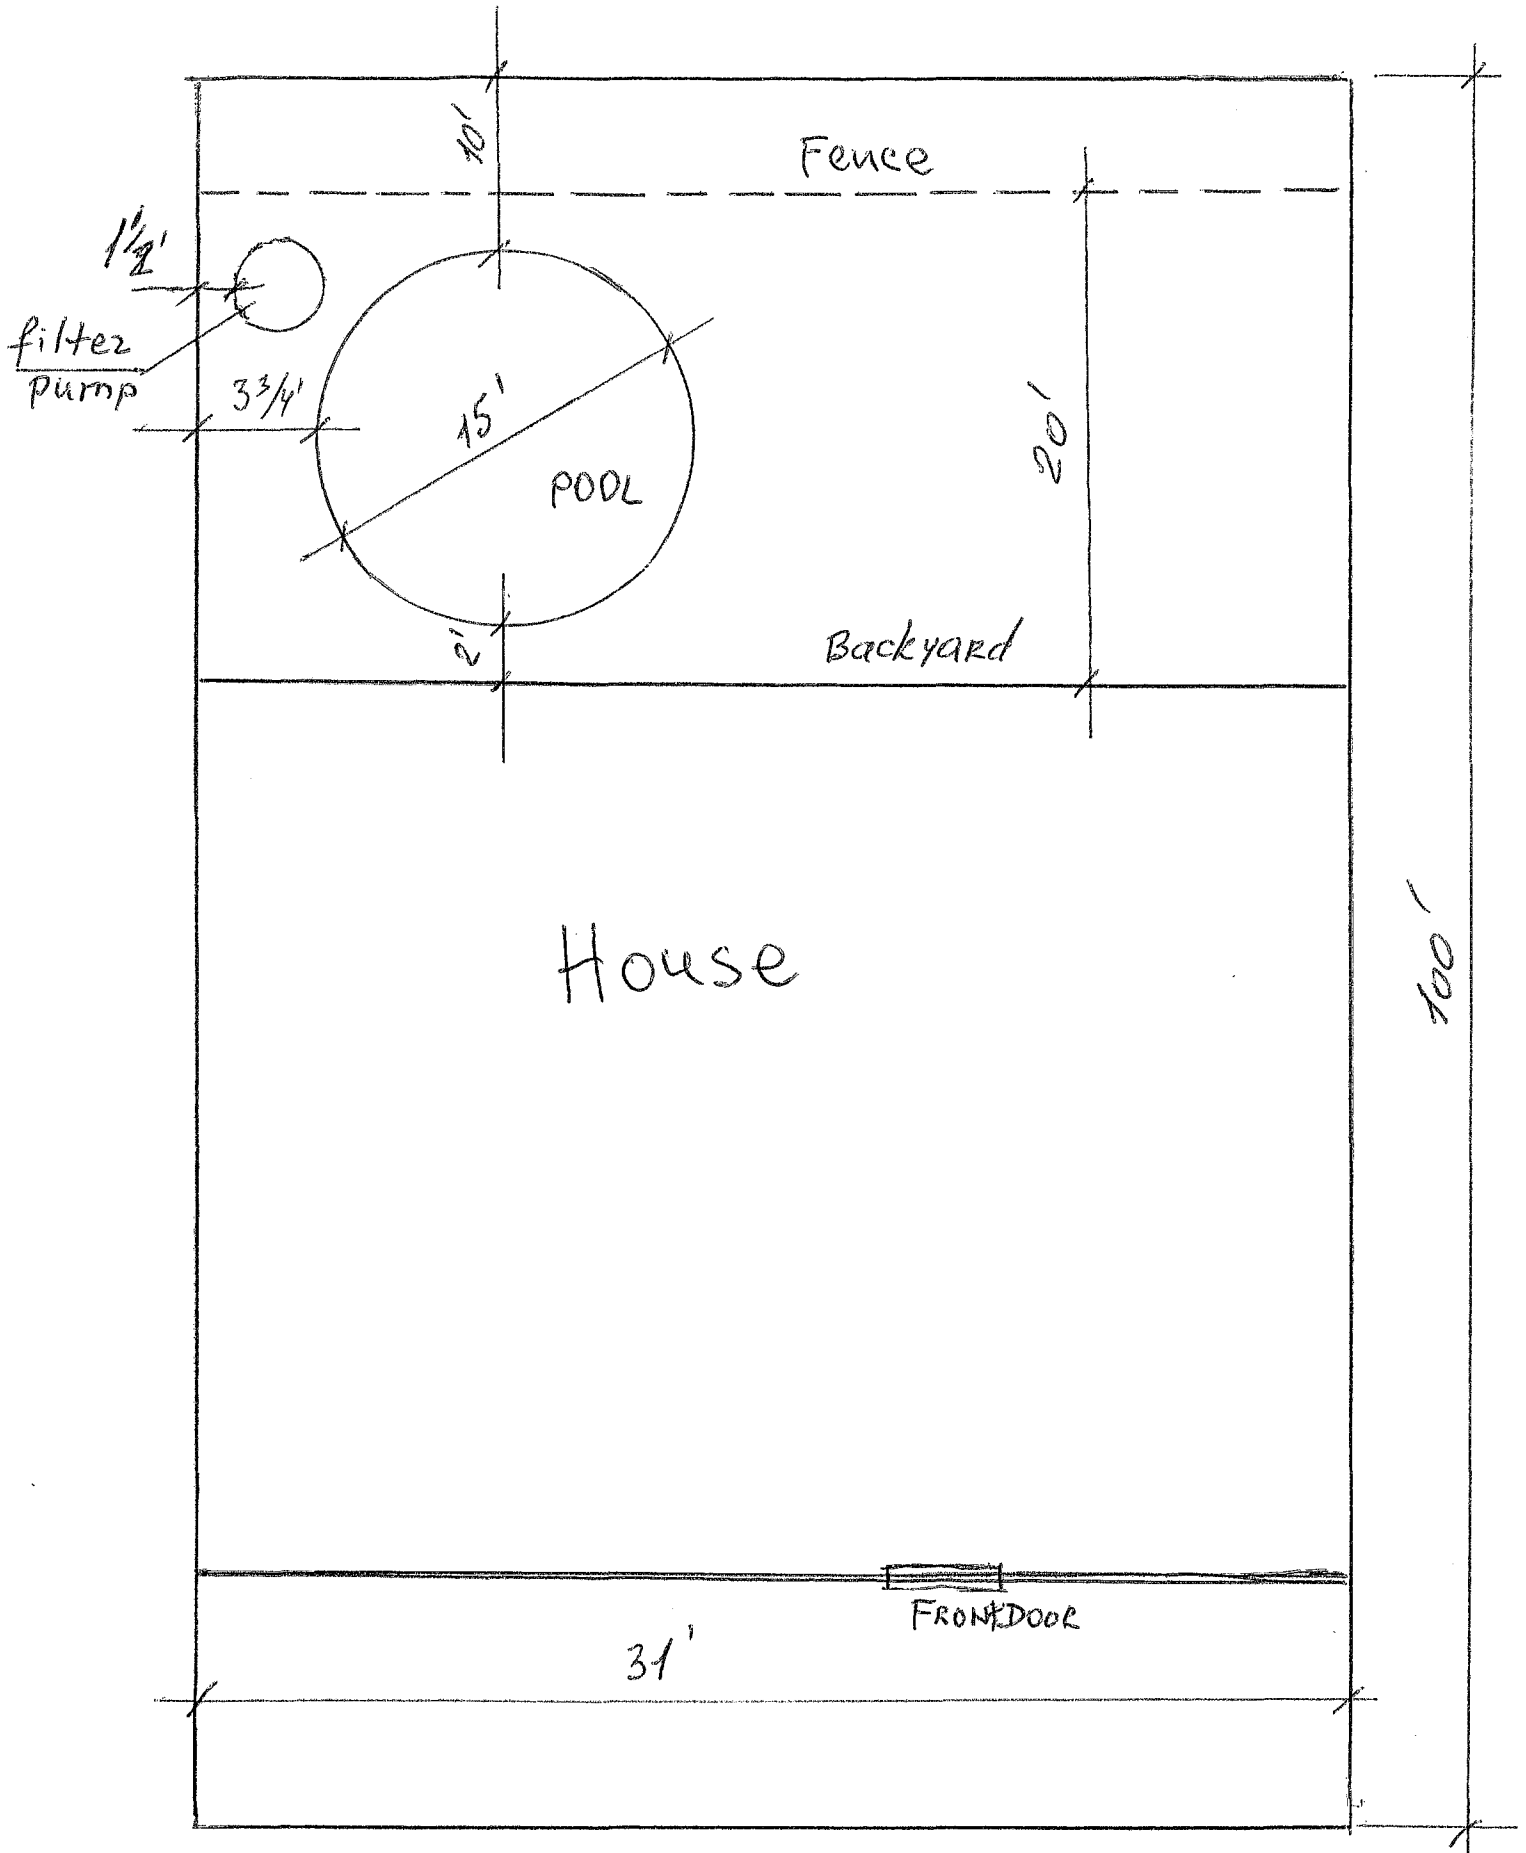

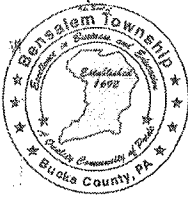

# BENSALEM TOWNSHIP

*Building and Planning Department*

Office 215-633-3644 • Fax 215-633-3753

Matthew K. Takita

*Director of Building and Planning*

2400 Byberry Road • Bensalem, PA 19020

July 7, 2016

STANISLAV MELIKOV  
3020 WISTAR CT  
BENSALEM, PA 19020

Project:	ABOVE GROUND POOL
Project Address:	3020 WISTAR CT BENSALEM, PA 19020
Tax Parcel:	02-090-156
Property Owner:	SAME AS ADDRESSED
Permit Status:	APPLICATION DENIED

## Electronic Review Status

Dear Sir/Madam:

A review was conducted on the application for the referenced project pursuant to Chapter 232 ZONING. The attached sheets show what was found during the review and this information is required to complete the permit application for the above referenced project.

The review process utilizes Adobe Acrobat allowing reviewers to make their comments directly on the plan pages. These comments are tracked throughout the review and a printed summary serves as the basis for a rejection on the project until required changes have been made. The attached sheets will show an image of the plan page including its associated comments with connector lines. Only those pages of the plans that require a revision have been generated and included.

You are required to resubmit plans with revisions and will need to burn the **complete** set of plans with revisions to a new disc. Return it to the Building & Planning Department. You are to include a summary list of **all** changes that were made to the plans including those required by the Township. For each change made to the plans, note the sheet number, drawing title, and a brief description of the change made. Please label the disc with the project address, date and revision number to distinguish it from any earlier submissions.

It is our intent that you receive as few rejections as possible and provide reviewers a more efficient method for completing the review by utilizing the comments summary. The print dialog box should include the following summary options:

- \* Layout - Document and comments with connector lines on single pages
- \* Font Size - Large font size
- \* Include - all comments
- \* **Clear** - the checkbox to NOT include pages containing no comments

It is possible that upon receipt of the revised plans, additional items for compliance may be required. This letter shall serve as formal notice that your permit application has been rejected for said project until such time as the requested information has been provided.

You have the right to appeal this rejection letter. Applications for the Zoning Hearing Board can be obtained from the Building and Planning Department located in the Municipal Building at 2400 Byberry Road, Bensalem.

Respectfully,

A handwritten signature in black ink, appearing to read "Matthew K. Takita".

Matthew K. Takita, A.I.A., M.C.P.  
Director of Building and Planning

[sm977@hotmail.com](mailto:sm977@hotmail.com)  
Email address

MKT/lva  
Enclosures


Summary of Comments on 20160705\_093700.pdf

Page: 1

Author: makia Subject: Zoning Rejected Date: 7/6/2016 10:40:38 AM


Author: makia Subject: Text Box Date: 7/6/2016 10:41:15 AM

The proposed pool setbacks are less than the required 10'. 232-588(a)

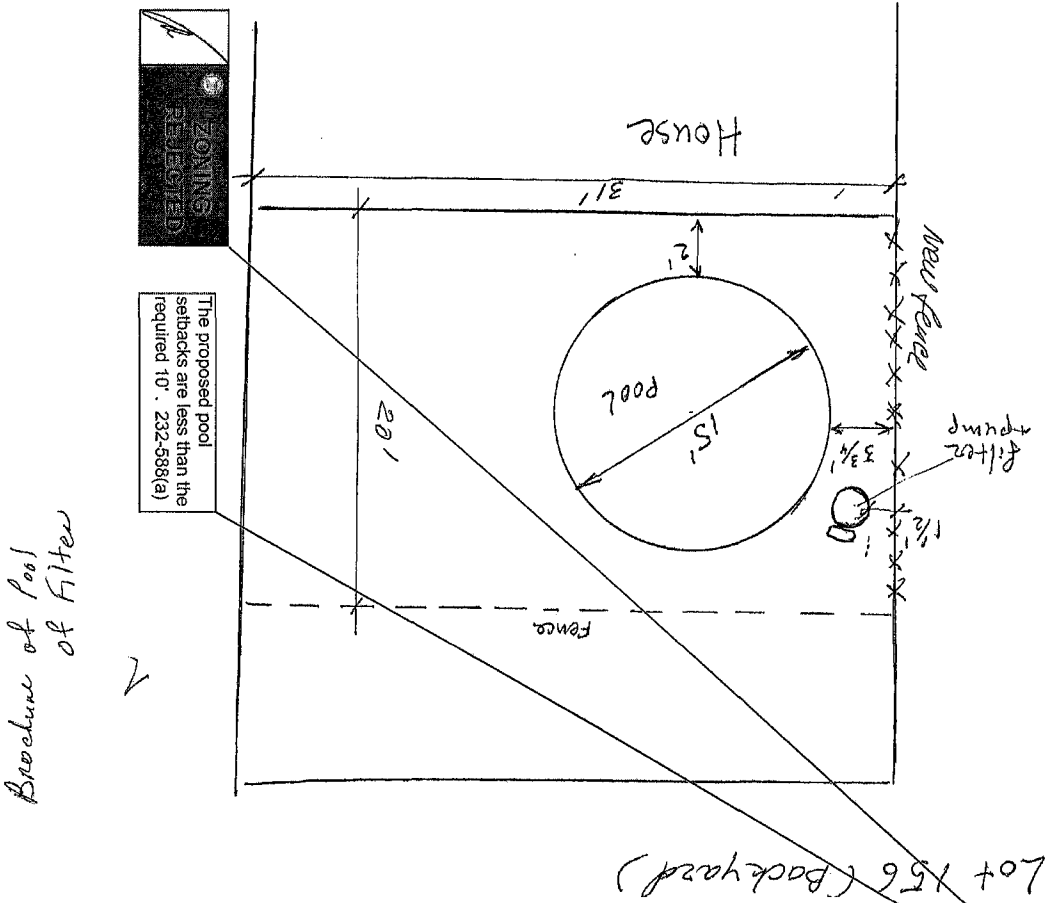

2-90-156  
3020 WISTAN

#4

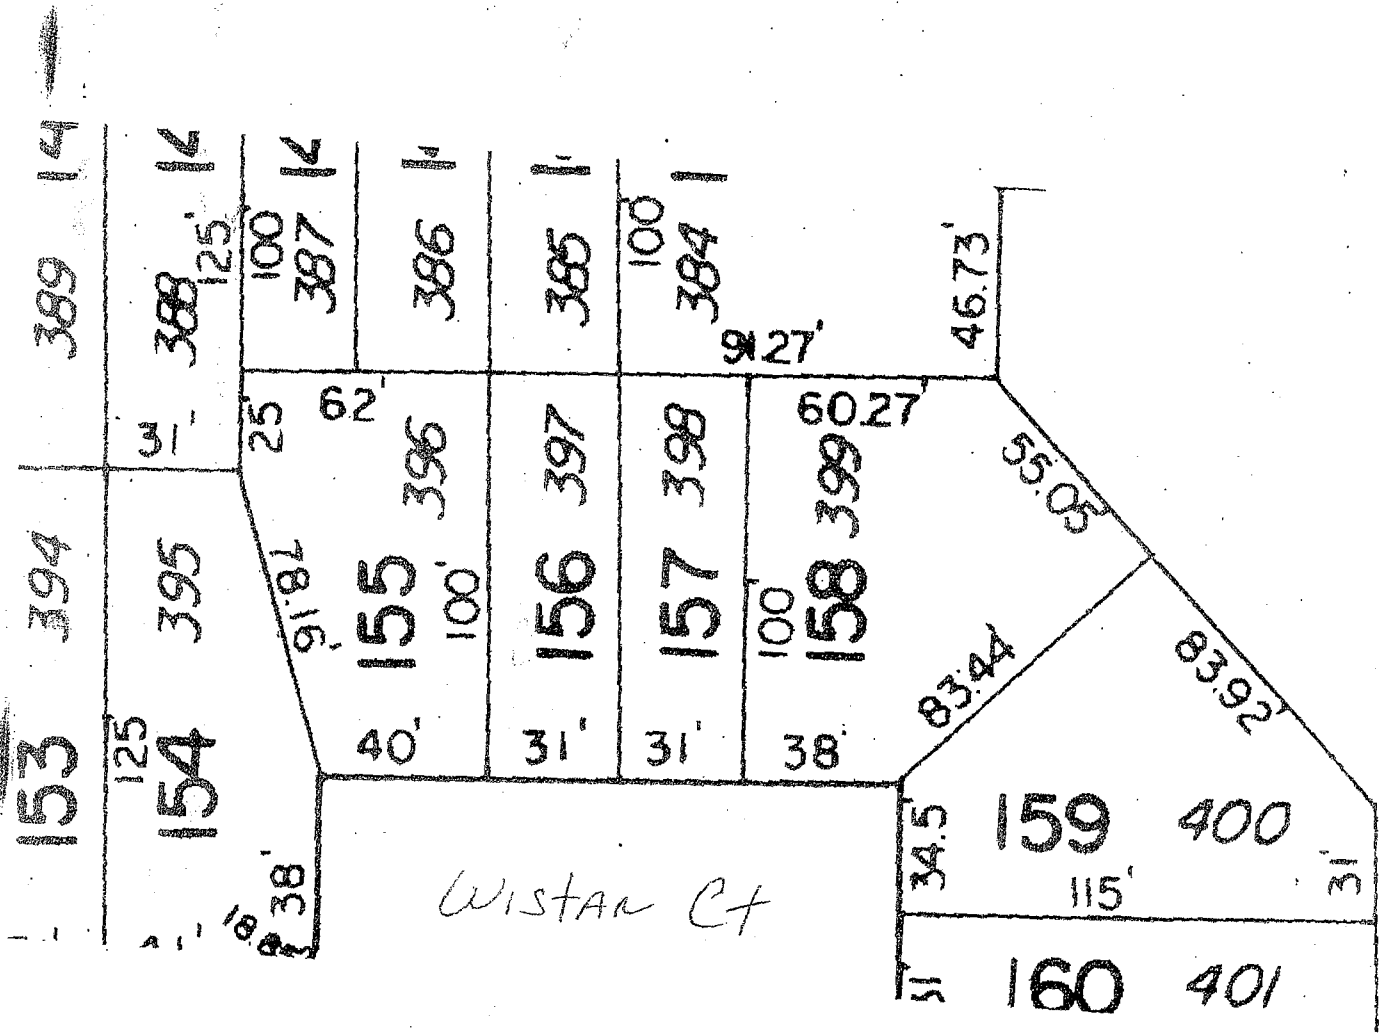

51498